

2 Bedrooms

No. 91-97

FEE 60.-

COMMONWEALTH OF MASSACHUSETTS

Board of Health, Bourne, MA.

APPLICATION FOR DISPOSAL SYSTEM CONSTRUCTION PERMIT

Application for a Permit to Construct () Repair () Upgrade () Abandon () - Complete System Individual Components

Table with 2 columns: Location, Map/Parcel#, Lot#, Installer's Name, Address, Telephone# and Owner's Name, Address, Telephone#. Handwritten entries include 90 Circuit Ave, 43.3/226, Gary Wing, and Robert Morse.

Type of Building, Dwelling - No. of Bedrooms, Other - Type of Building, Design Flow, Plan: Date, Title, Description of Soil(s), Soil Evaluator Form No., Name of Soil Evaluator, Date of Evaluation.

DESCRIPTION OF REPAIRS OR ALTERATIONS: notify BOH at time of excavation. TIMBERS w/ ML POLY BARRIER. Permit valid for repair of septic only - System does not meet all Title 5 requirements...

The undersigned agrees to install the above described Individual Sewage Disposal System in accordance with the provisions of TITLE 5 and further agrees to not to place the system in operation until a Certificate of Compliance has been issued by the Board of Health.

Signed: Gary W. Wing (Bill) Date 5/9/97. Approved: Cynthia A. Coffin. Inspections: Disapproved - Need better plan - need to show slope out + grading - Call 5/12/97 - spoke to Mr. Wing.

No. 91-97 FEE 60.-

COMMONWEALTH OF MASSACHUSETTS

Board of Health, Bourne, MA. Permit valid for repair of septic only - System does not meet all Title 5 requirements and/or local Board of Health requirements - System not adequate for any additions / renovations / replacement or upgrades of sanitary sewage facilities / conversions.

CERTIFICATE OF COMPLIANCE

Description of Work: Individual Component(s) Complete System

The undersigned hereby certify that the Sewage Disposal System; Constructed (), Repaired (), Upgraded (X) Abandoned ()

by: Gary Wing at 90 Circuit Ave.

has been installed in accordance with the provisions of 310 CMR 15.00 (Title 5) and the approved design plans/as-built plans relating to application No. 91-97, dated 6/23/97. Approved Design Flow 343 (gpd)

Installer: Gary Wing Designer: Inspector: Cynthia A. Coffin Date: Feb. 2, 1998

The issuance of this permit shall not be construed as a guarantee that the system will function as designed.

No. 91-97 FEE 60.-

COMMONWEALTH OF MASSACHUSETTS

Board of Health, Bourne, MA. Permit valid for repair of septic only - System does not meet all Title 5 requirements and/or local Board of Health requirements - System not adequate for any additions / renovations / replacement or upgrades of sanitary sewage facilities / conversions.


DISPOSAL SYSTEM CONSTRUCTION PERMIT

Permission is hereby granted to; Construct () Repair () Upgrade (X) Abandon () an individual sewage disposal system at 90 Circuit Ave as described in the application for

Disposal System Construction Permit No. 91-97, dated 6/23/97.

Provided: Construction shall be completed within three years of the date of this permit. All local conditions must be met.

Date 6/23/97 Board of Health Cynthia A. Coffin. notify BOH at time of excavation

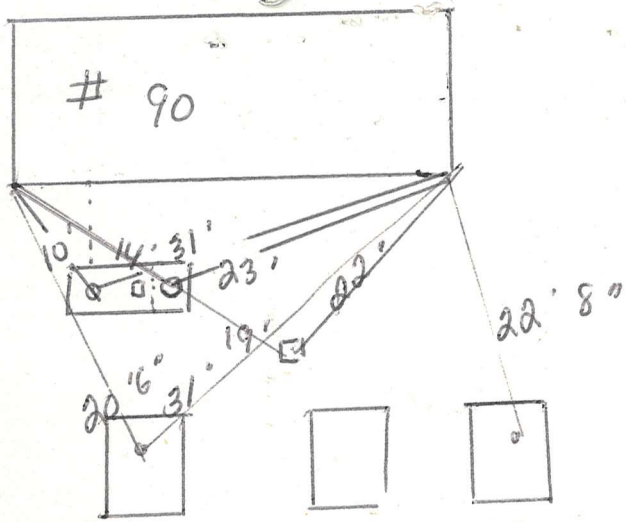


Circuit ave



TOWN OF BOURNE

BOARD OF HEALTH
BOURNE, MASS.

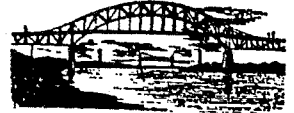

CYNTHIA A. COFFIN, HEALTH AGENT

6/23/97

OWNER: Robert Morse

ADDRESS: Concord NH

Dear Mr. Morse,

This letter is to inform you that a septic permit # 91-97,
for a repair/upgrade of the septic system at 90 Circuit Ave,
Pocasset has been approved by this office on 6/23/97.

Please be advised that the proposed repair/upgrade does not meet all the requirements of 310 CMR 15.00, Title 5, such as setback distances and distance to groundwater, and/or does not meet the Board of Health regulation regarding distance to wetlands. This repair/upgrade is approved solely as an improvement to an existing failed or non-Title 5 system.

The above permit is not valid for any future additions of habitable space or renovations/reconstruction of the referenced dwelling or replacement or upgrades of sanitary waste facilities, i.e. plumbing work. The aforementioned types of work would require a variance(s) from 310 CMR 15.00, Title 5 and/or existing Board of Health regulations.

Please contact this office at 759-0630 if you have any questions.

Sincerely,

Cynthia A. Coffin, R.S., C.H.O.
Health Agent