

FIRST FLOOR PLAN
 SCALE: 1/4" = 1'-0"

AREA	
1ST FLOOR	2,177 SF
2ND FLOOR	1,364 SF
BASEMENT	36 SF
TOTAL	3,577 SF
GARAGE	467 SF

- (SM) INDICATES SMOKE & CARBON MONOXIDE DETECTORS
- (H) INDICATES HEAT DETECTORS

RECEIVED
 By Bourne Health Department at 2:54 pm, Dec 13, 2022

STAMP:

W.B. DANIELS
 ARCHITECTURAL DESIGN
 PH 508-958-7132 E-Mail: daniele01@comcast.net

NEW HOME
 AT
 68 ELGIN ROAD
 POCASSETT, MA.

TITLE:
 FIRST FLOOR PLAN

DATE ISSUED:
 10/06/2022

REVISIONS:


DRAWN BY:

PROJECT #:

DRAWING NO.:

A1

11 December 2022 8:38 AM
 C:\Users\wbdaniels\Documents\1st Floor\1st Floor.dwg

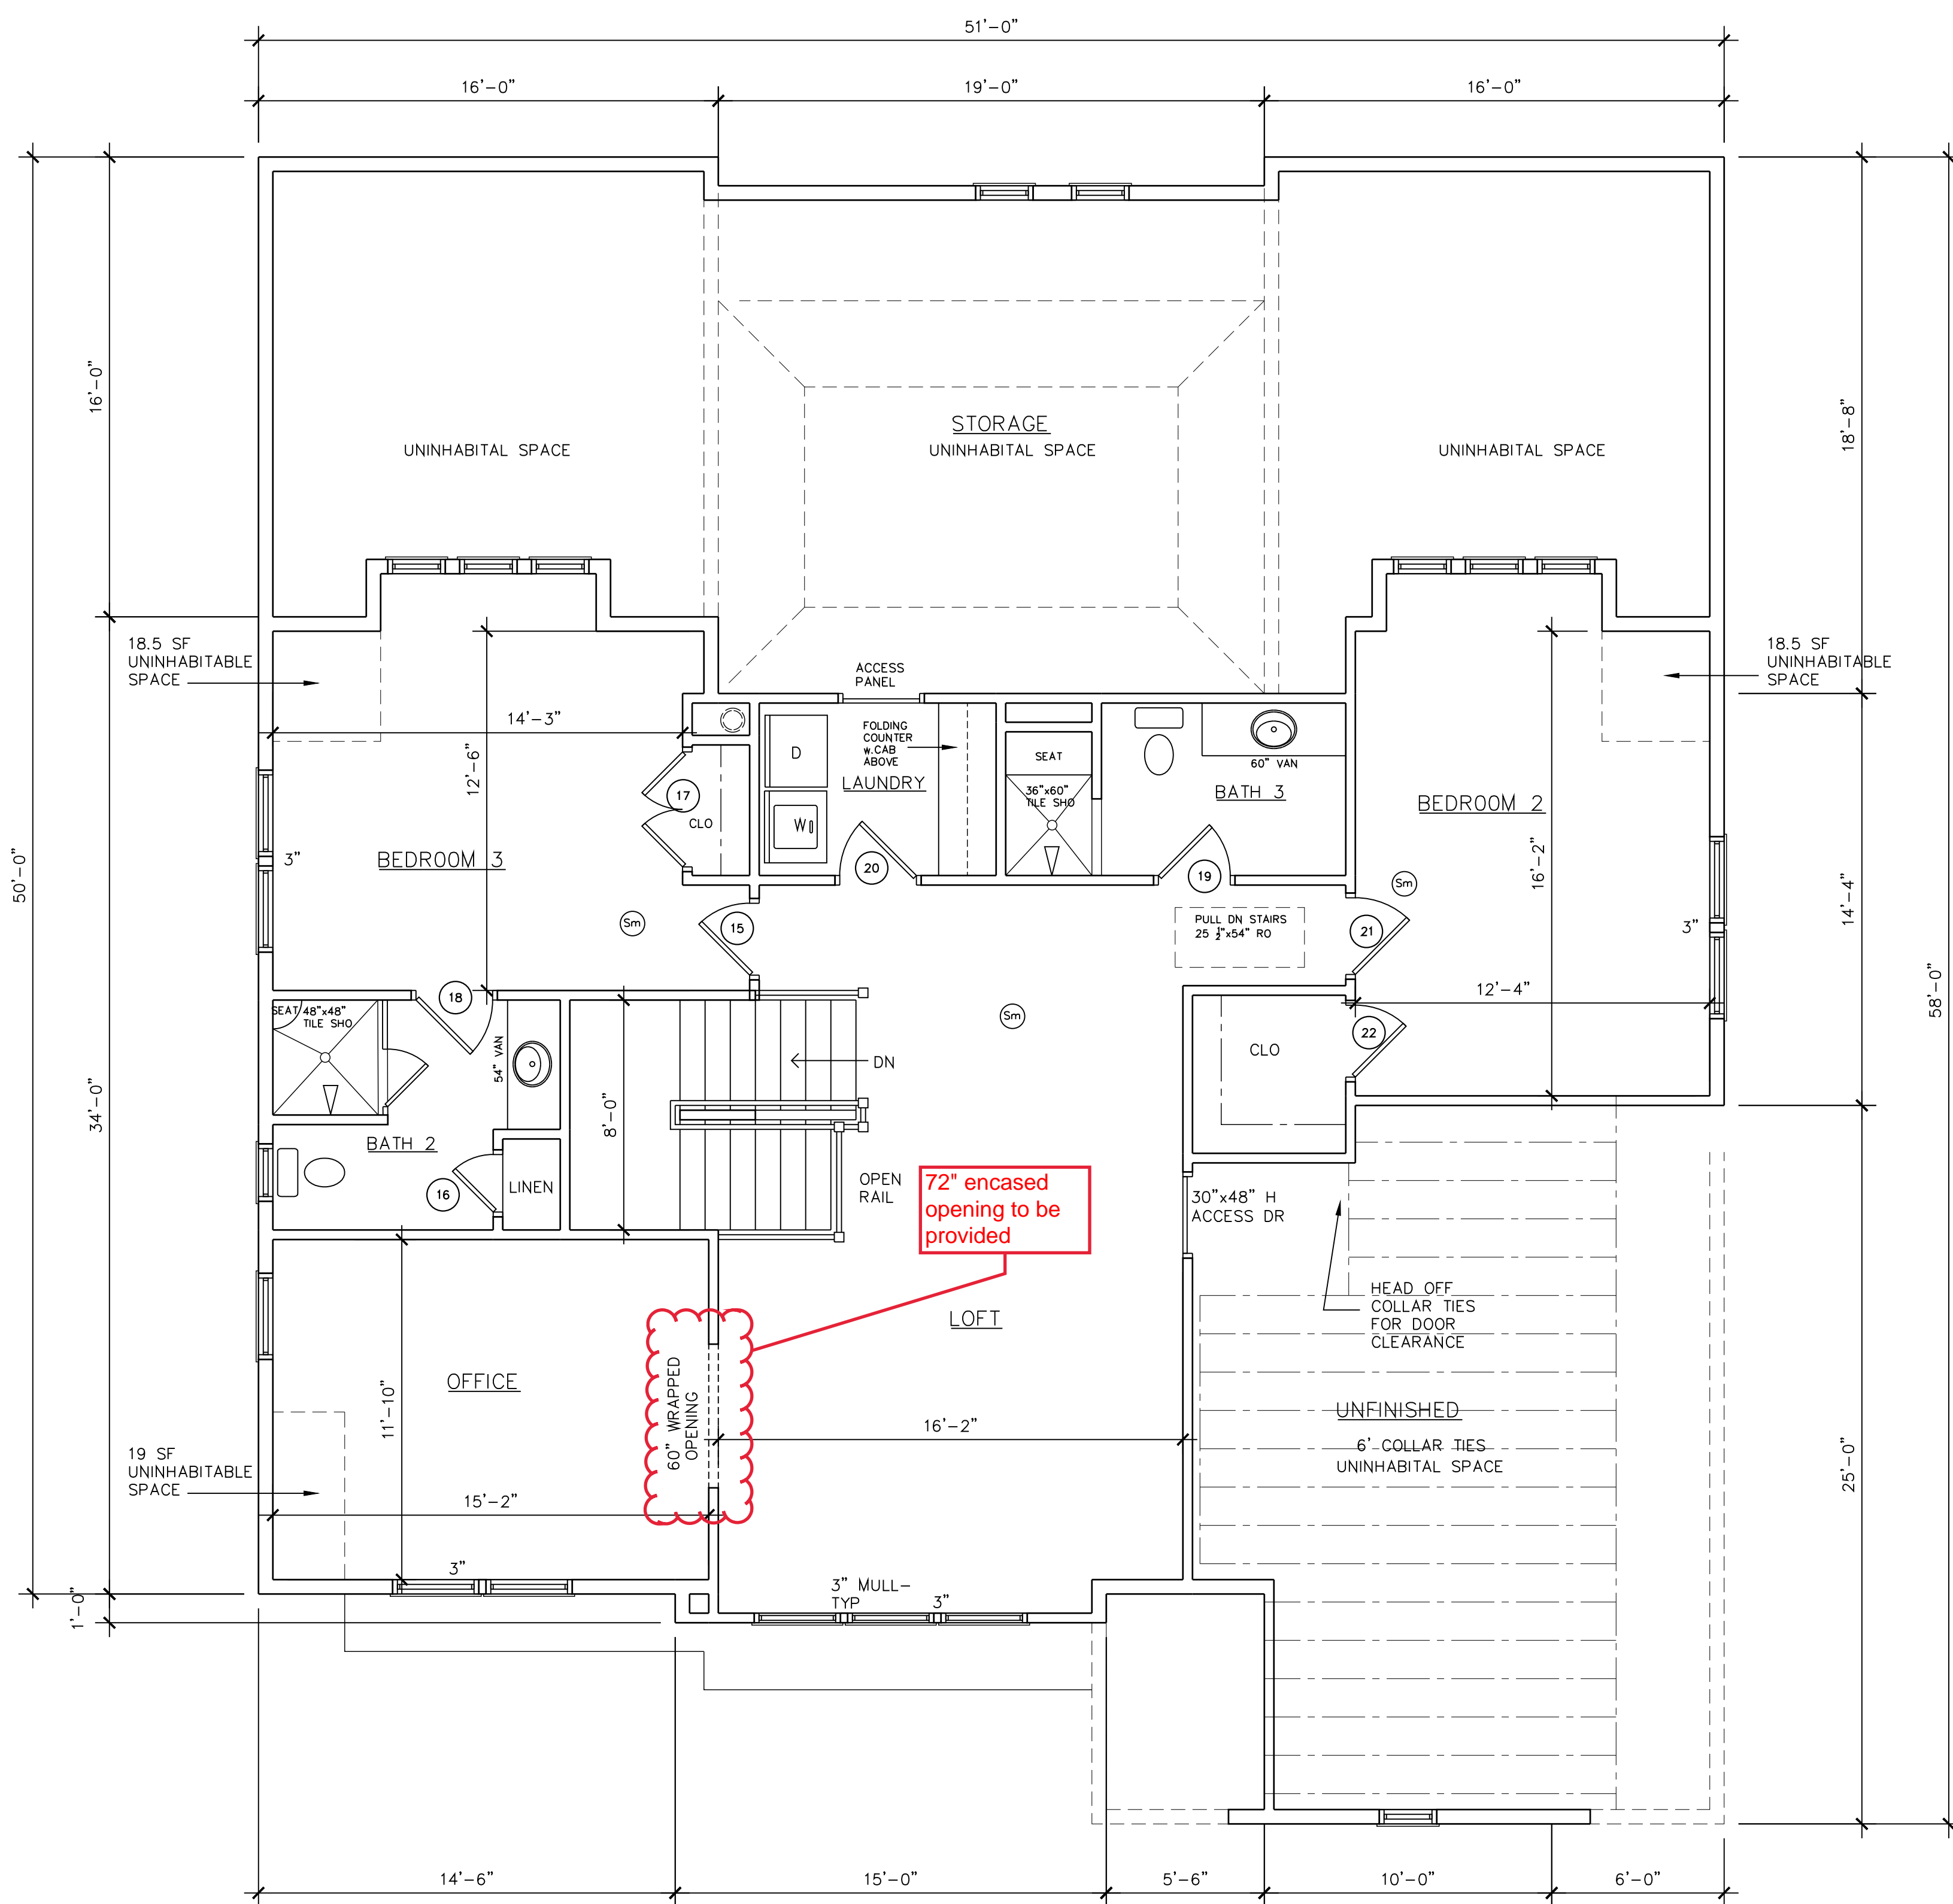

○ SECOND FLOOR PLAN
SCALE: 1/4" = 1'-0"

STAMP:

W.B. DANIELS
ARCHITECTURAL DESIGN
PH 508-958-7132 E-Mail: daniels011@comcast.net

NEW HOME
AT
68 ELGIN ROAD
POCASSETT, MA.

TITLE:
SECOND FLOOR
PLAN

DATE ISSUED:
10/06/2022

REVISIONS:

DRAWN BY:

PROJECT #:

DRAWING NO.:

A2

STAMP:

W.B. DANIELS
ARCHITECTURAL DESIGN
PH 508-958-7132 E-Mail: daniels01@comcast.net

NEW HOME
AT
68 ELGIN ROAD
POCASSETT, MA.

TITLE:

ELEVATIONS

DATE ISSUED: 10/06/2022

REVISIONS: ---

DRAWN BY:


PROJECT #:

DRAWING NO.:

A3



FRONT ELEVATION
SCALE: 1/4" = 1'-0"

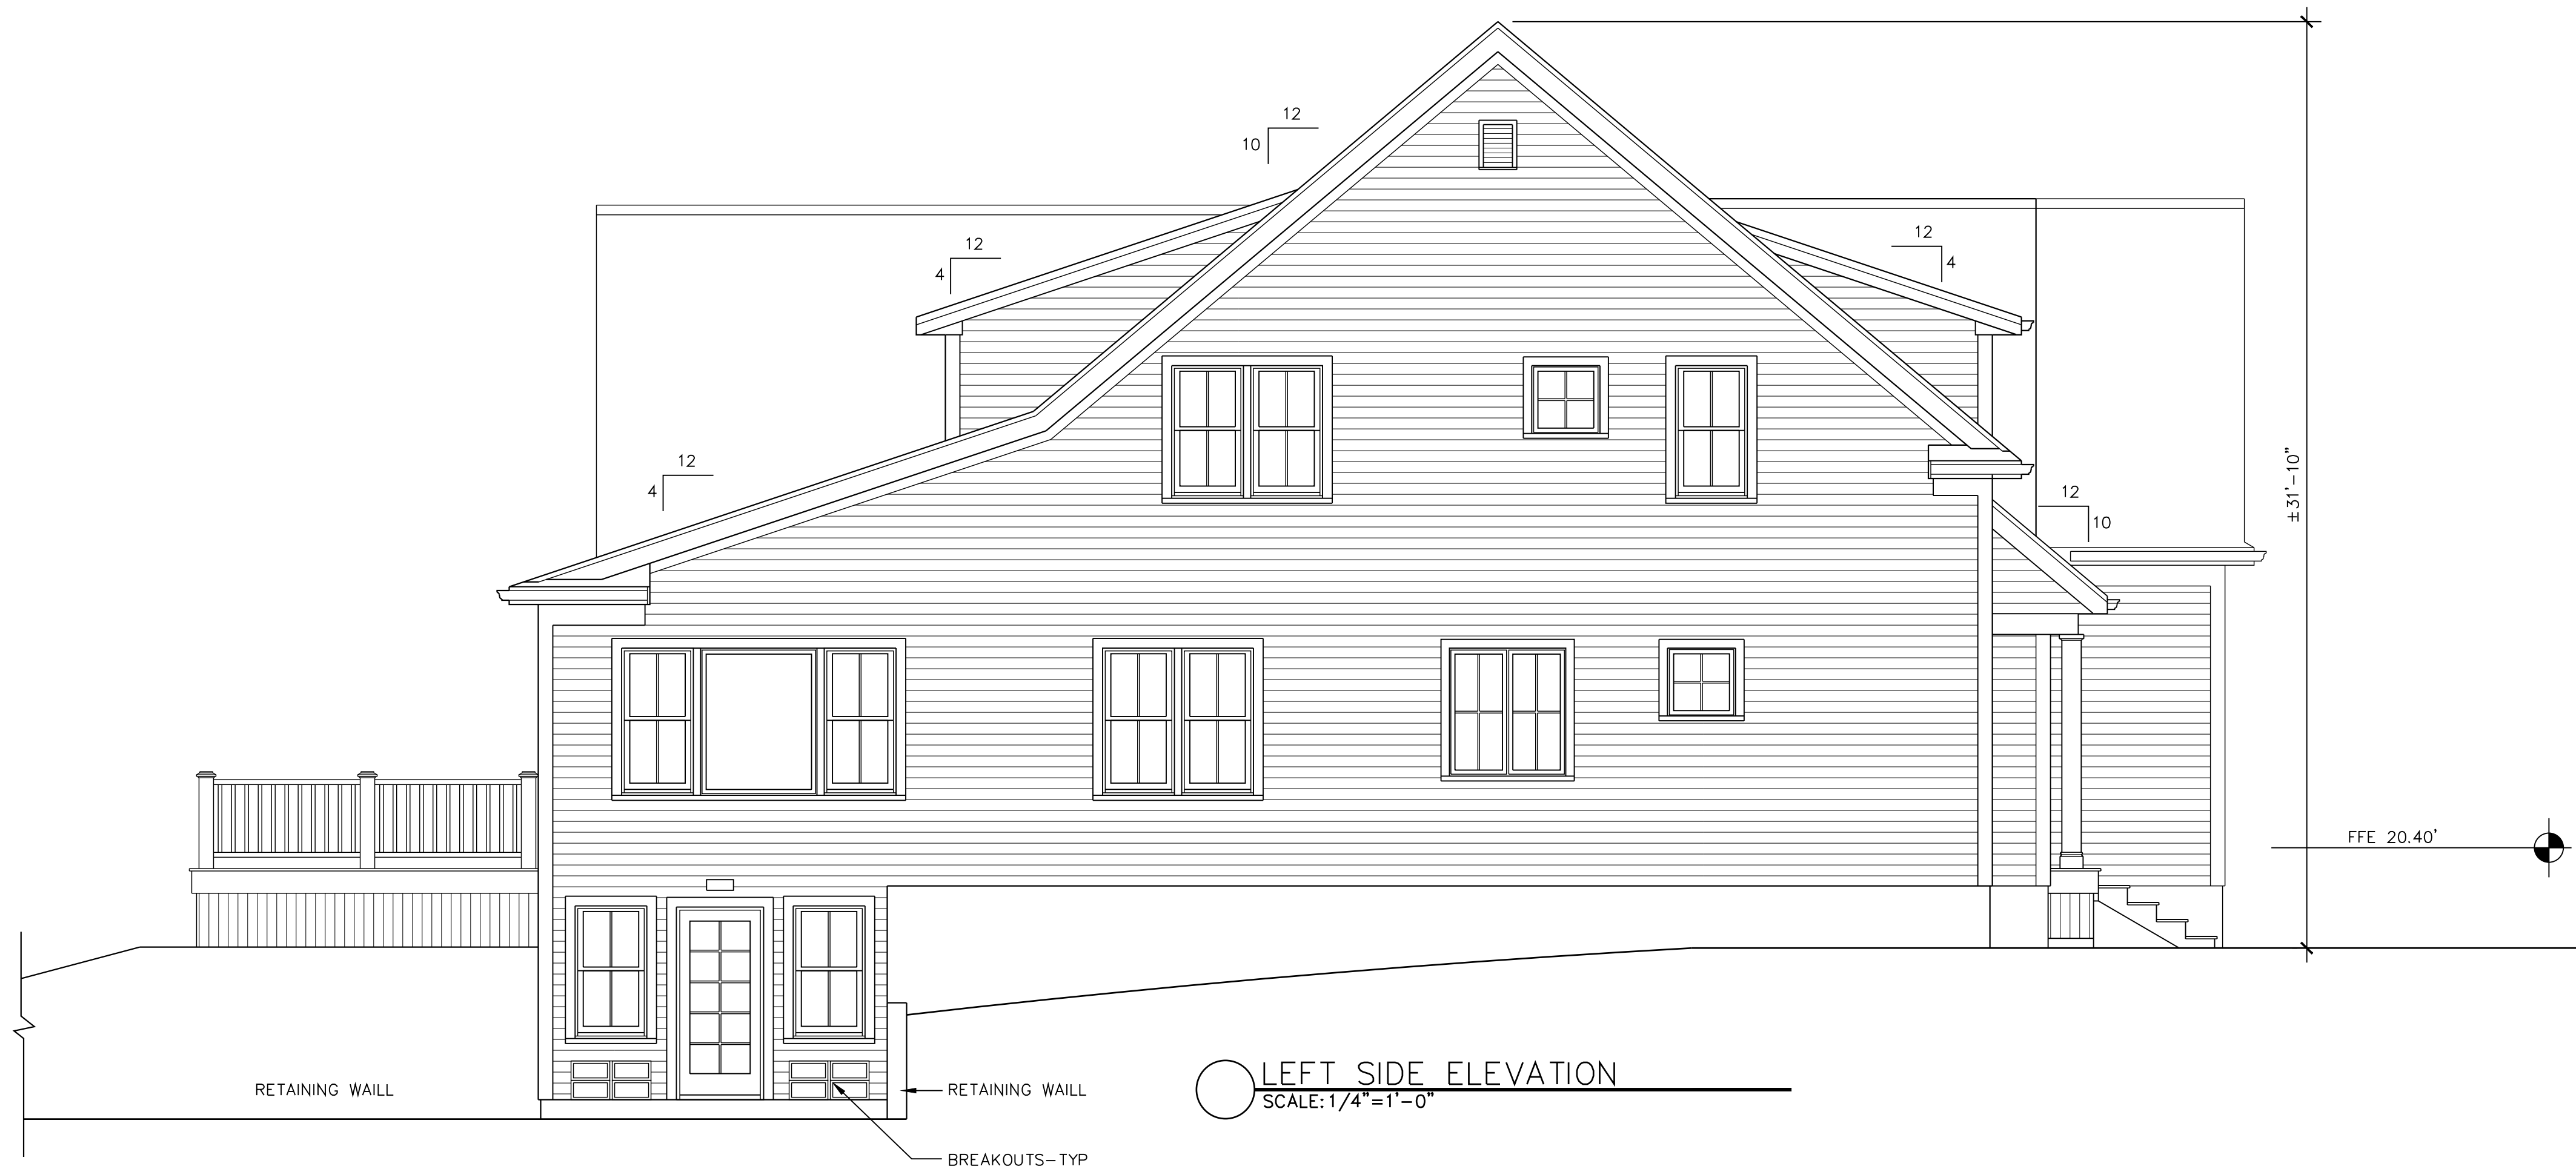

LEFT SIDE ELEVATION
SCALE: 1/4" = 1'-0"

11 December 2022 8:30 AM
C:\Users\wbdaniels\Documents\68 Elgin\2022\10-06-2022\10-06-2022.dwg

